Rte 180
St Louis County
Pipe Replacement
Exhibit B

As-Built Plans (1970)
Project # Sec 96(1) U

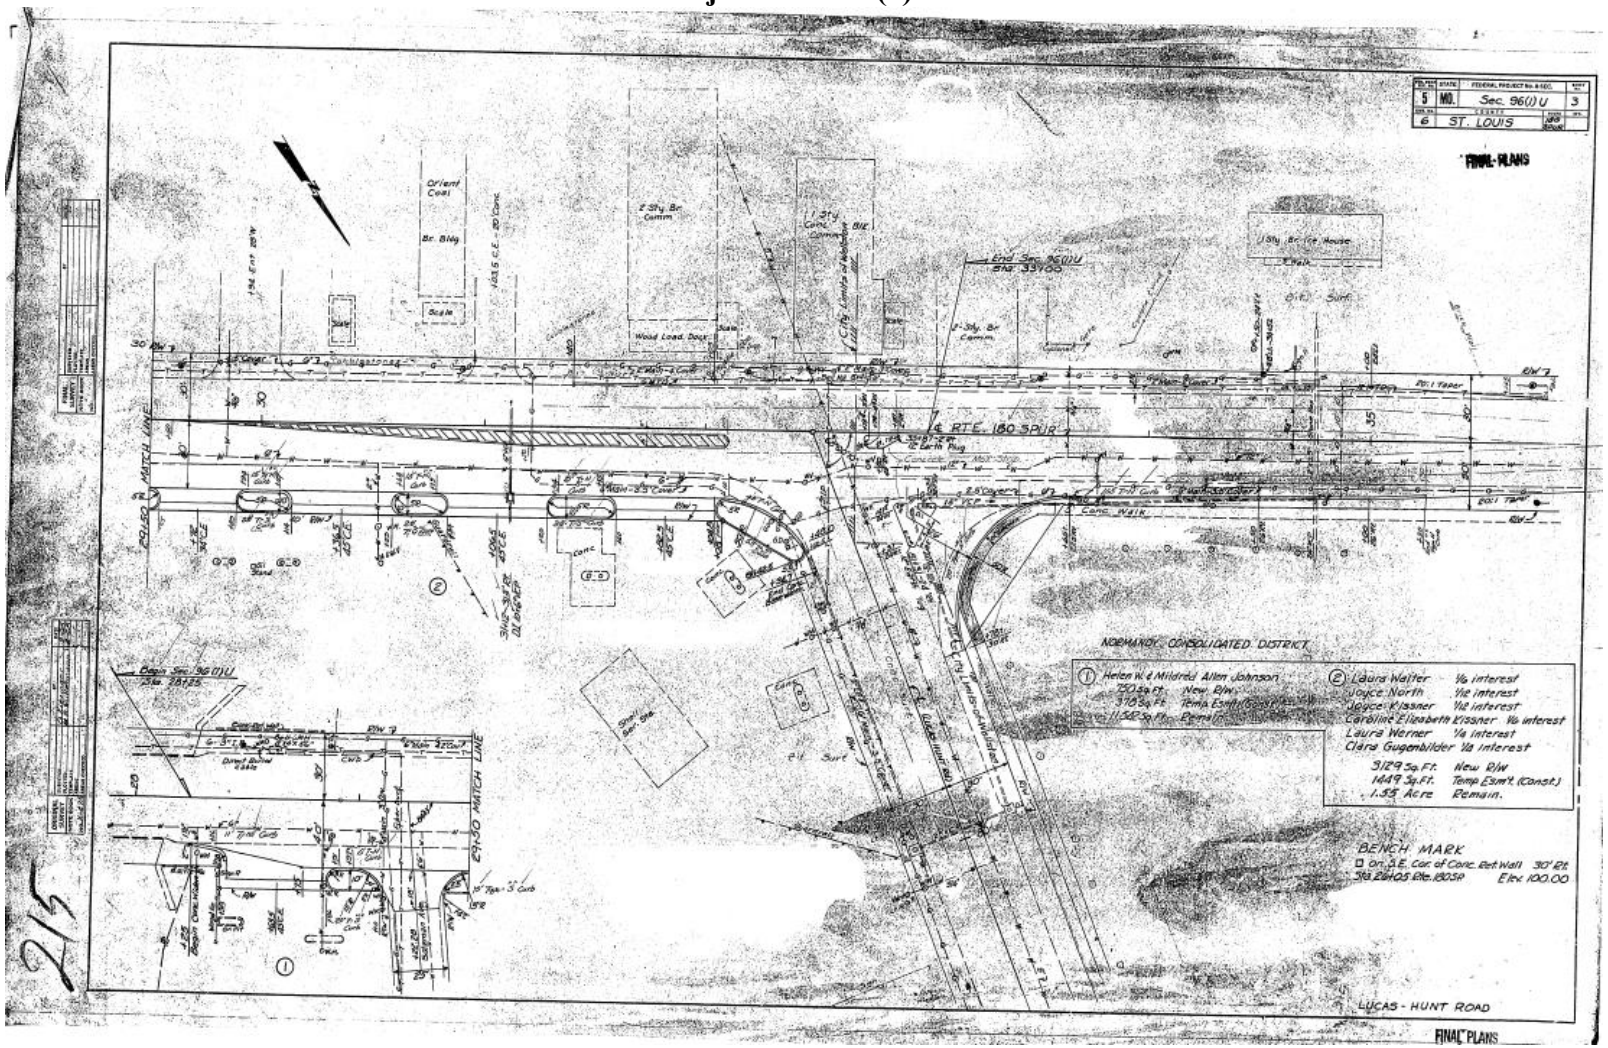
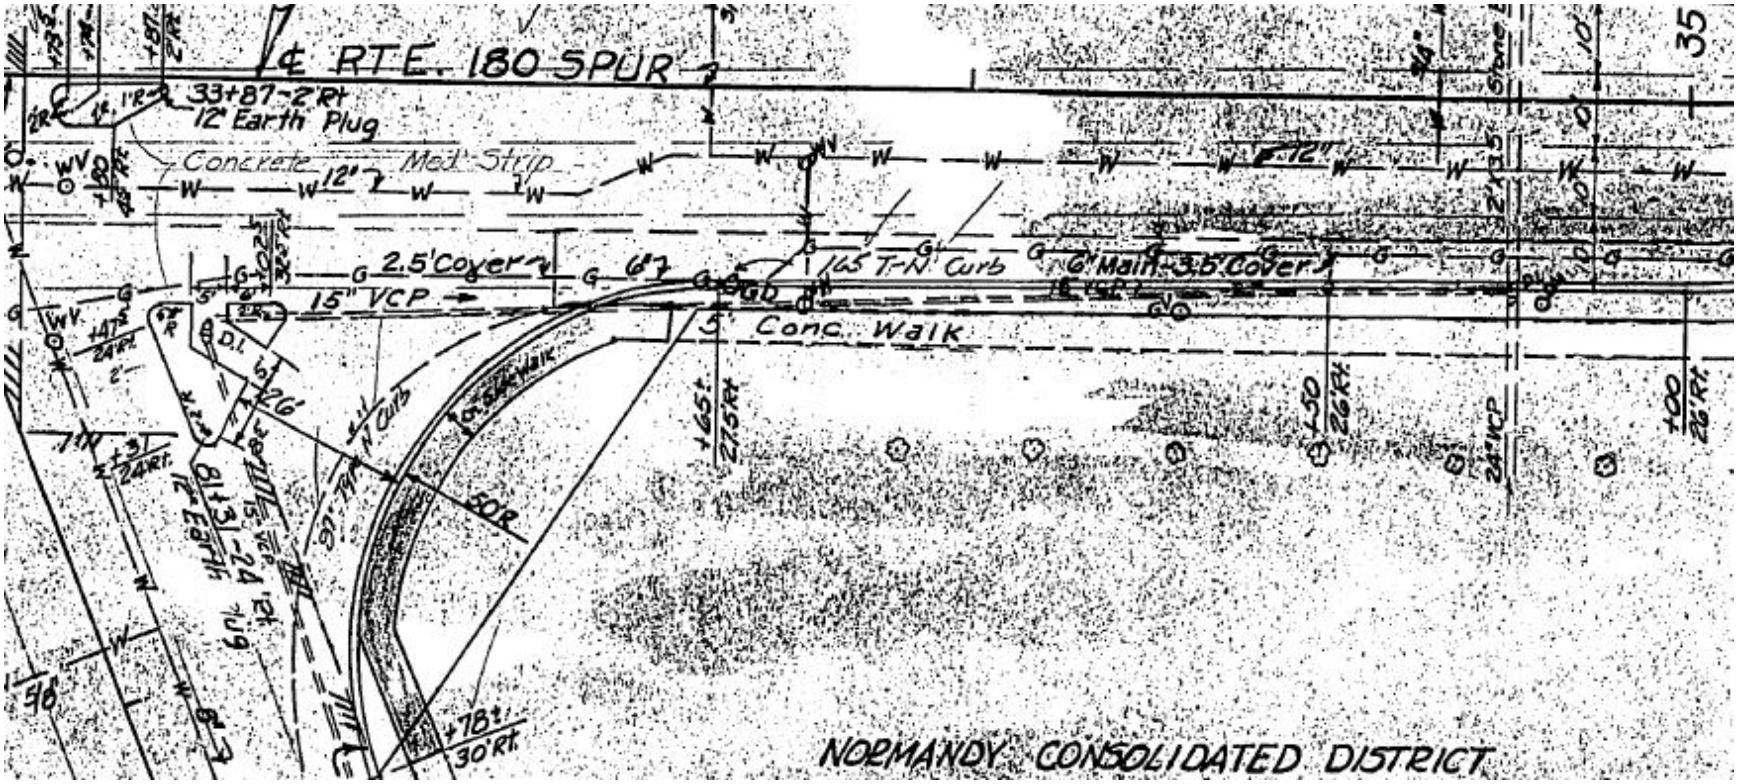
Replace Existing 15” Pipe